

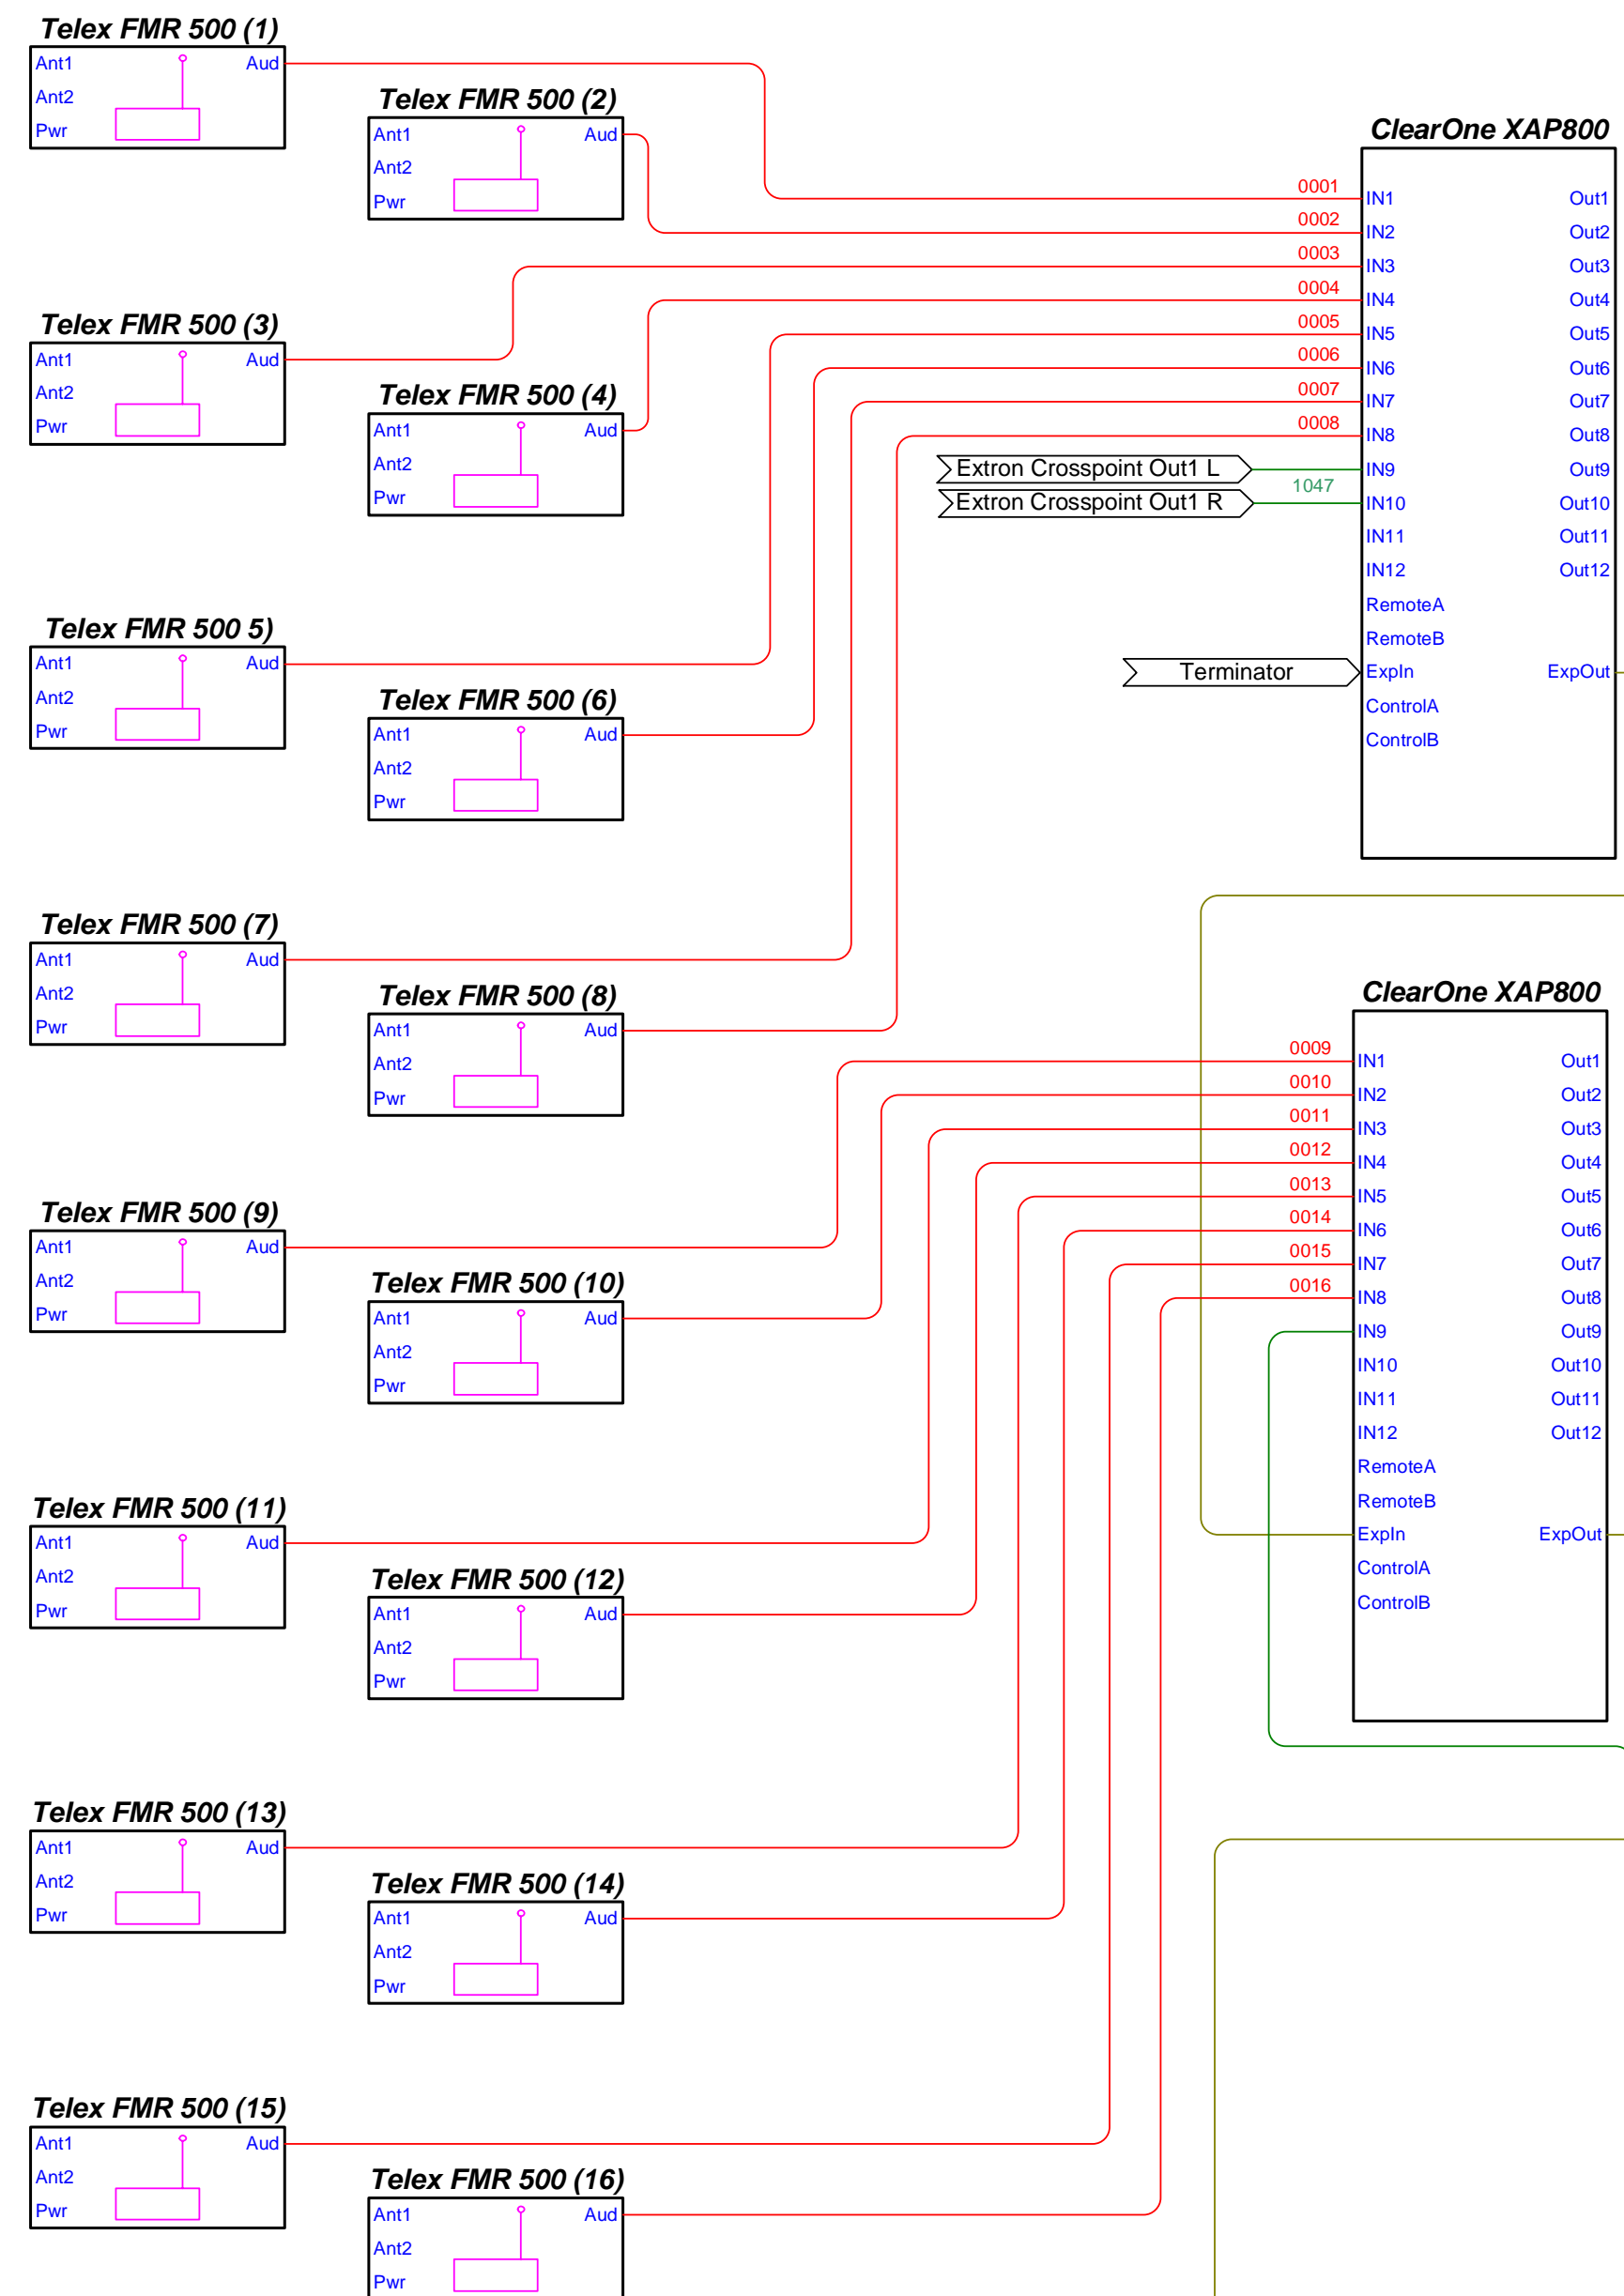
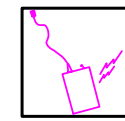



Typical of 14 Units
Wireless Boundary
Microphone
Units 1-14

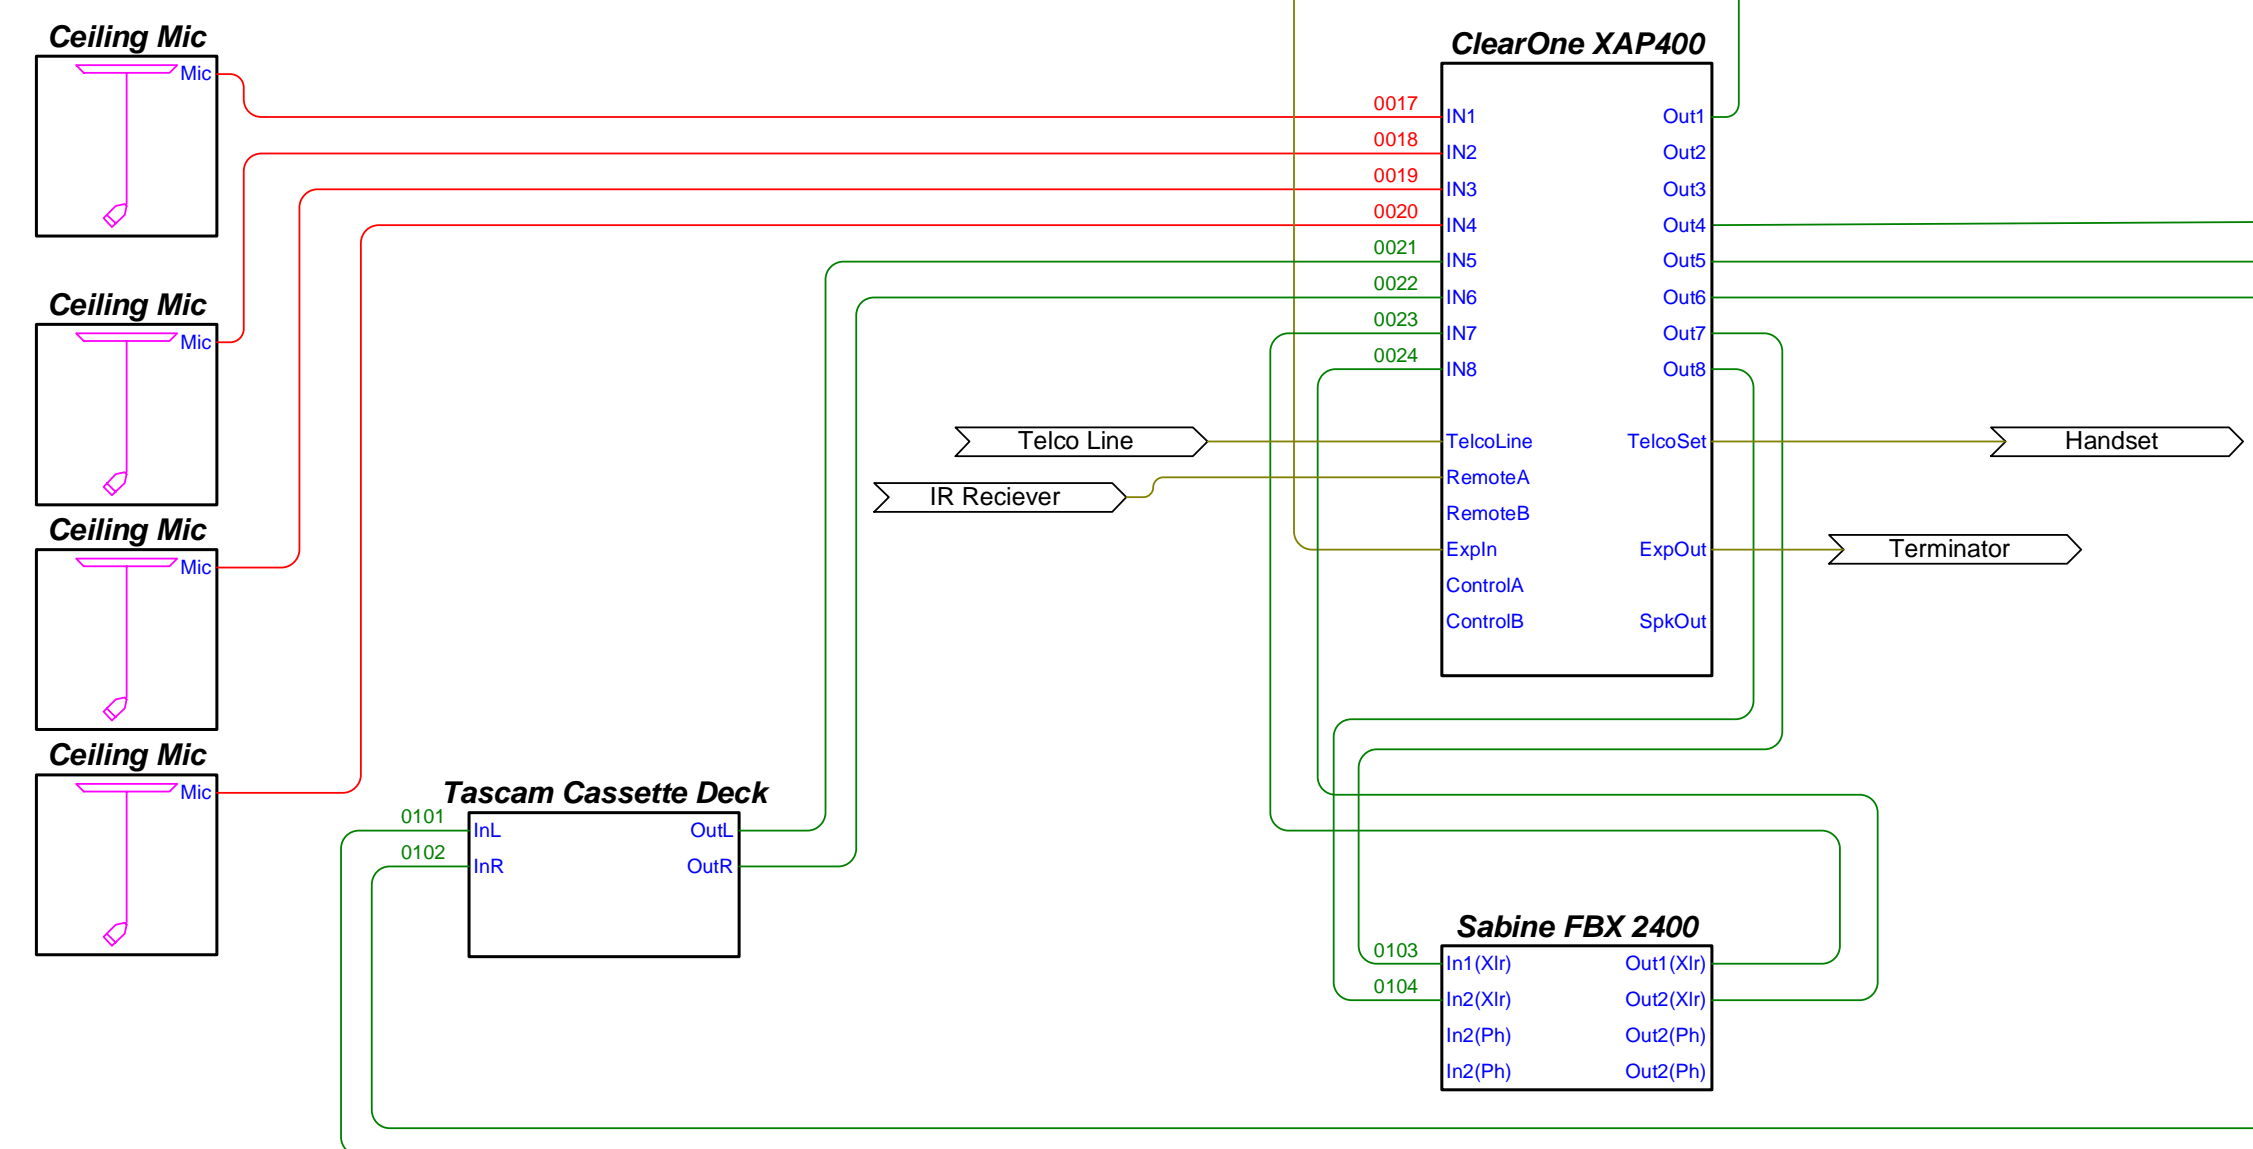

Typical of 2 Units
Wireless Lapel
Microphone
Units 15-16

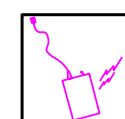

SIXTEEN RECEIVERS WITH FIVE SPLITTERS
AND TWO ANTENNAS

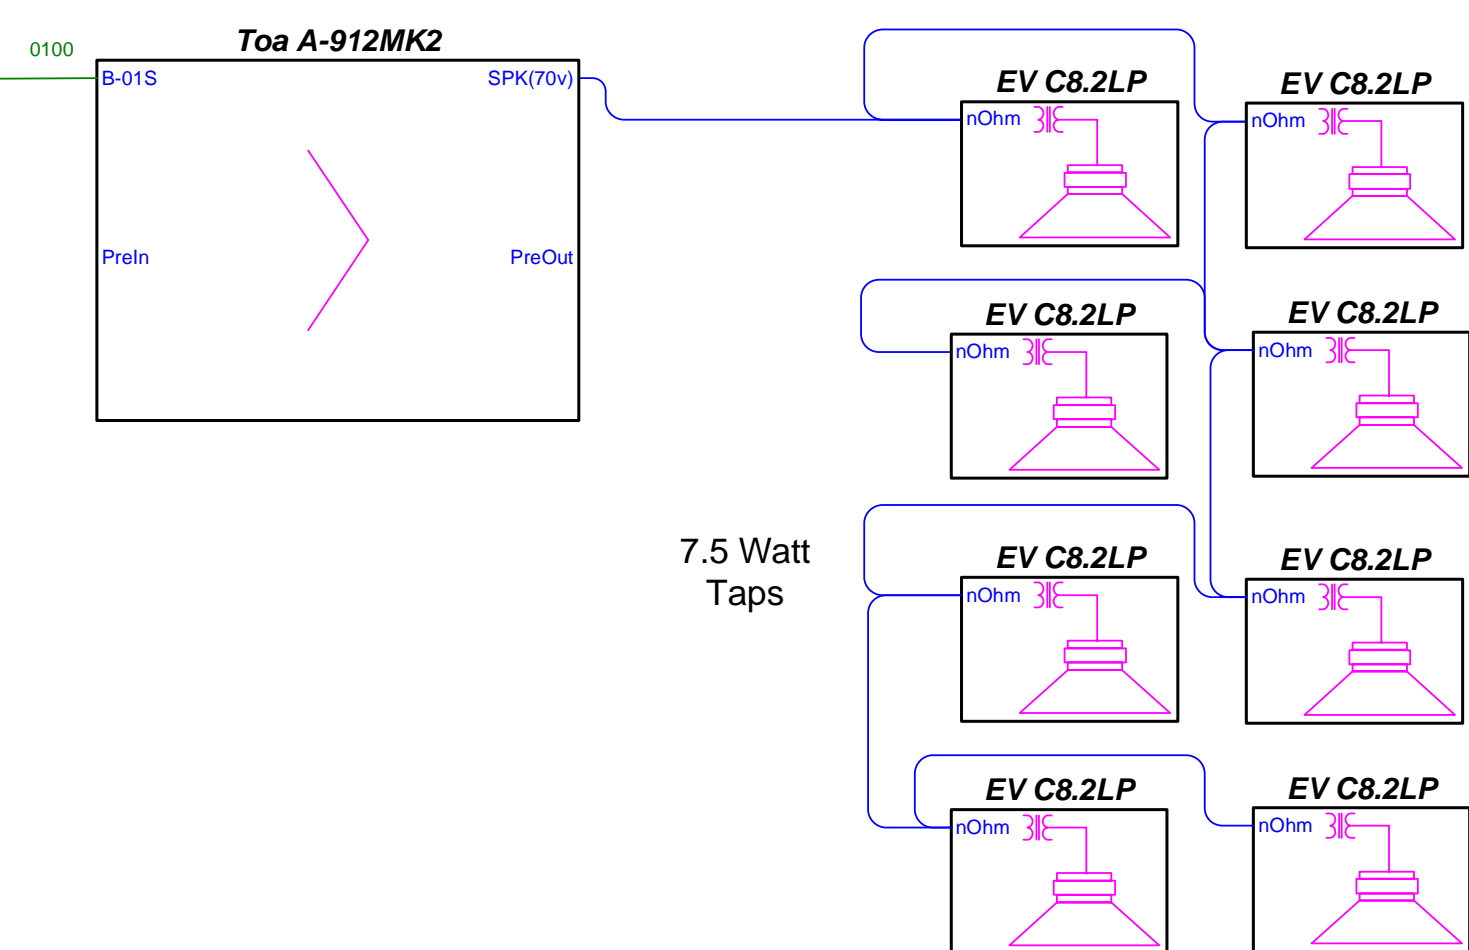

Wiring Index

Audio - Microphone	0000-0999
Audio - Line	1000-1999
Audio - Speaker	2000-2999
Control	3000-3999
Video - Composite/Svideo	4000-4999
Video - VGA/Component	5000-5999
Video - RF	6000-6999
Power	7000-7999
Fiber	8000-8999
Spare	9000-9999

Last Rev:	As-Built	08/02/07
Print Date:		11/14/07
Proj. Eng:		
Drawn By:		11/11/07















FRONTIER
MEDIA SOLUTIONS, LLC.

P.O. Box 634
Springboro, Ohio 45066
Tel: 937.704.9731 Fax: 937.704.0006
www.frontiermediasolutions.com

CUSTOMER	Christ Hospital
PROJECT	MA4538
DWG TITLE	Audio Block
ma4538.vsd	DWG NUMBER MA4538
SCALE 1.00 in.:1.00 in.	AV 01

Wiring Index

Audio - Microphone	0000-0999
Audio - Line	1000-1999
Audio - Speaker	2000-2999
Control	3000-3999
Video - Composite/Svideo	4000-4999
Video - VGA/Component	5000-5999
Video - RF	6000-6999
Power	7000-7999
Fiber - Category	8000-8999
Spare	9000-9999

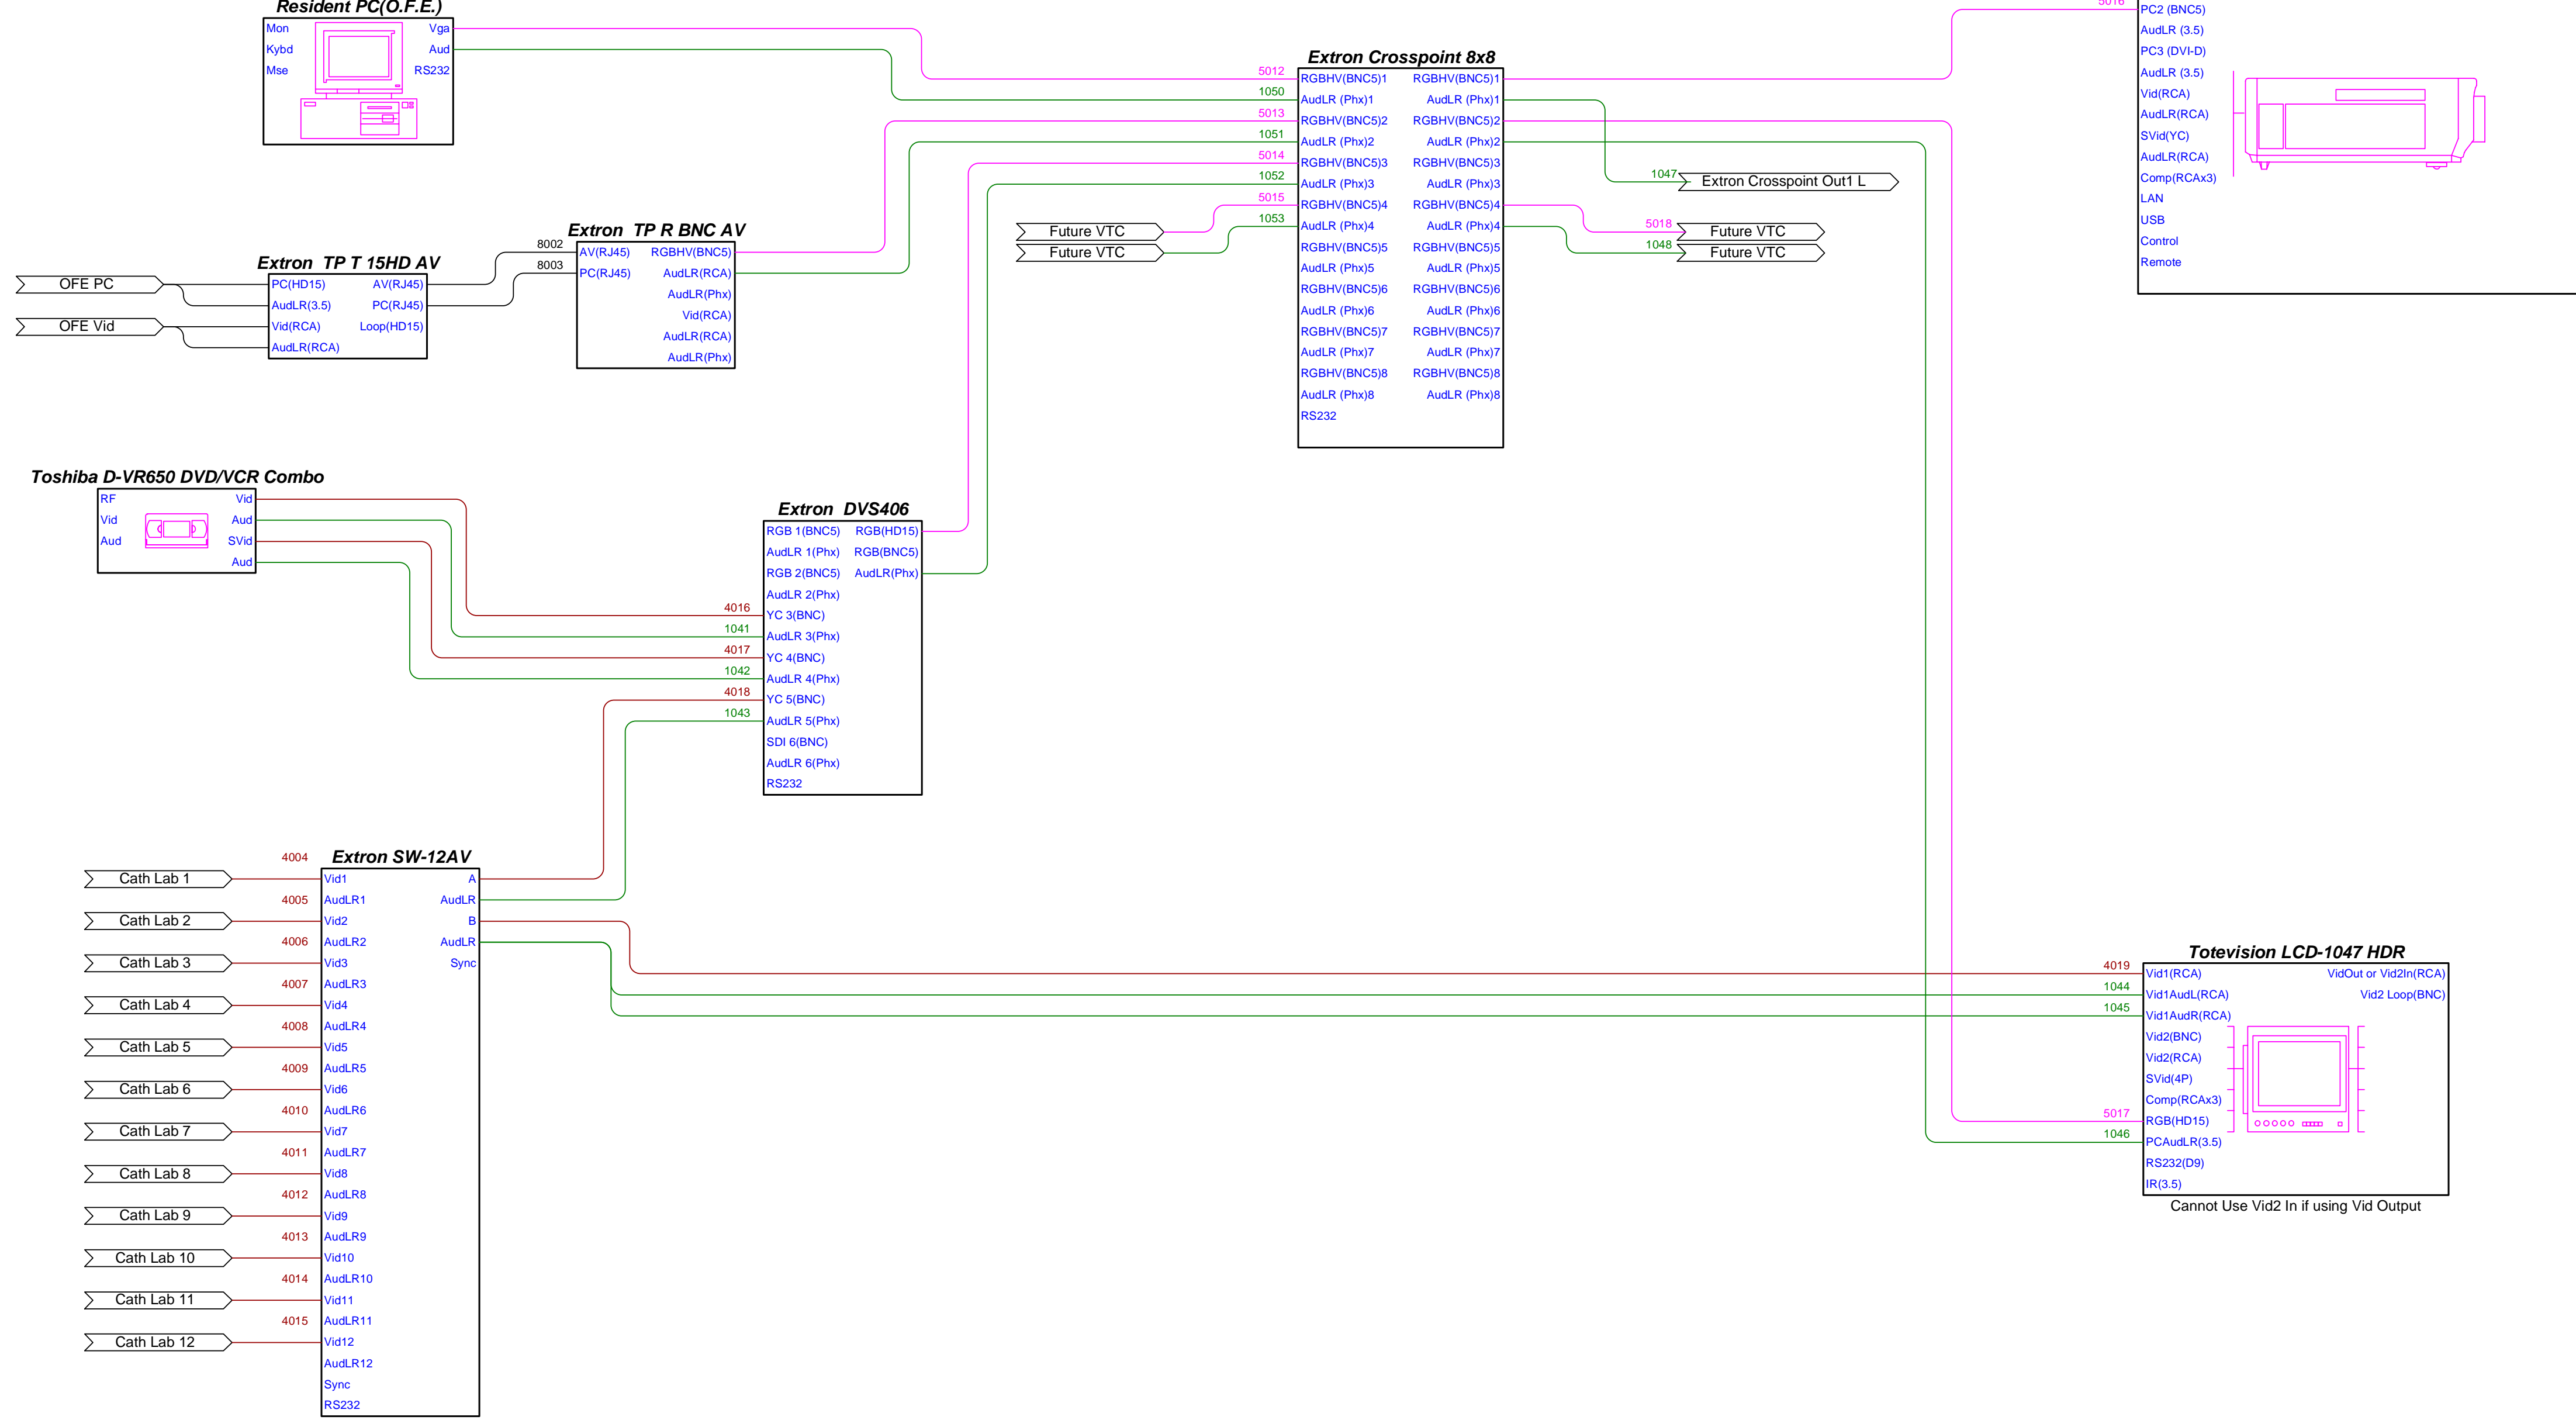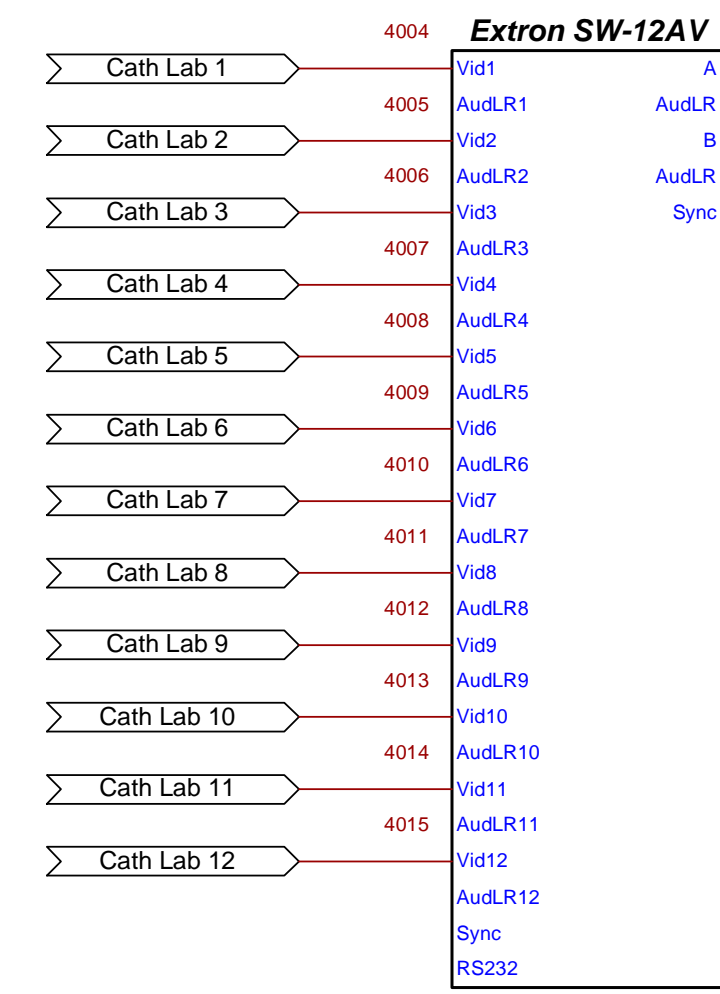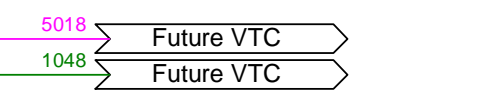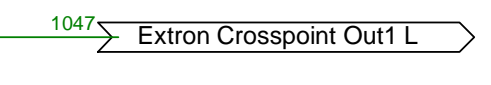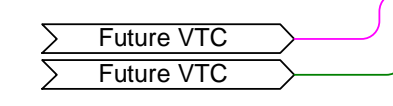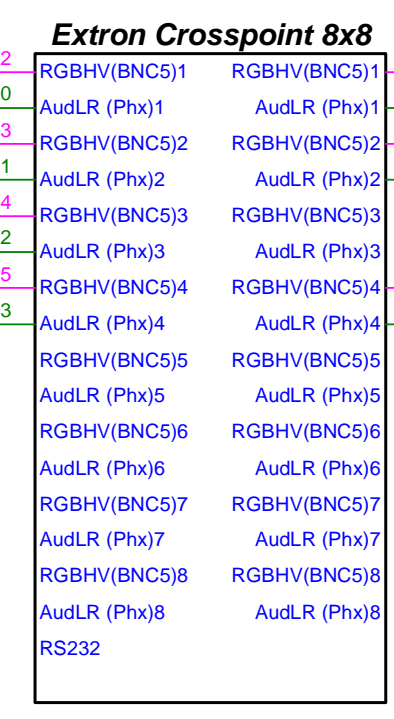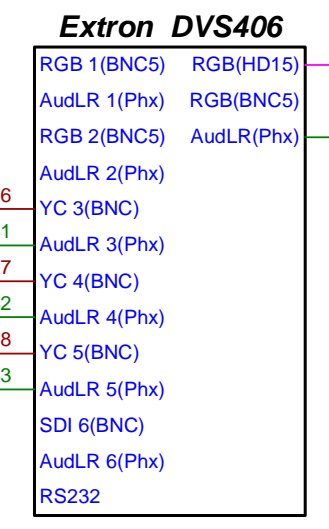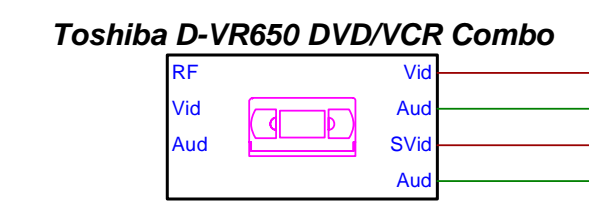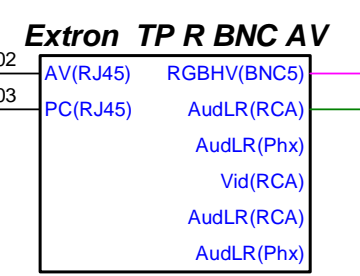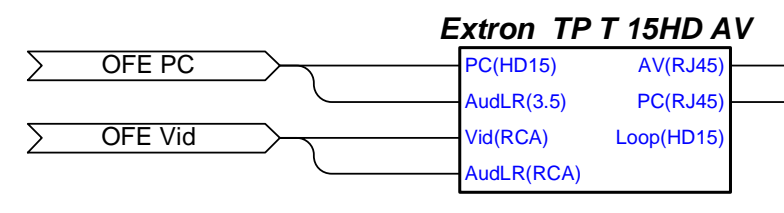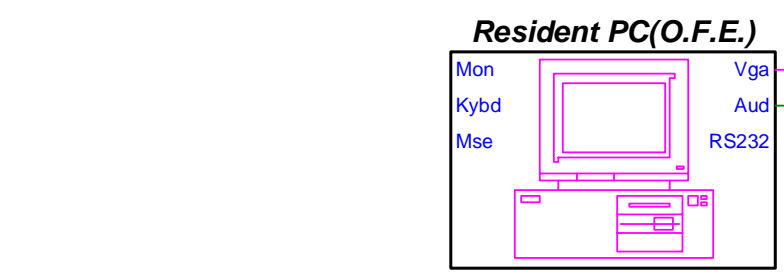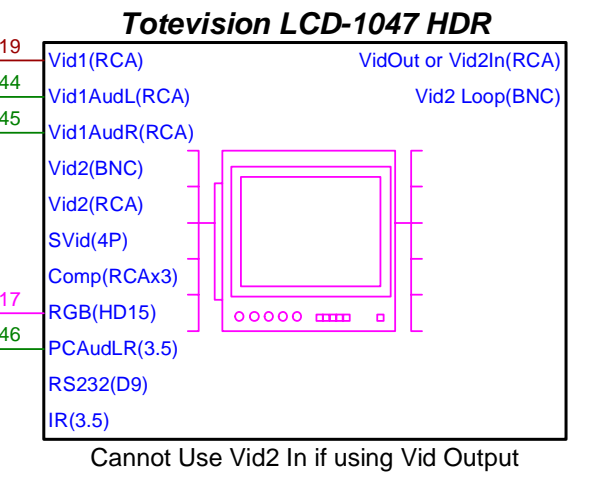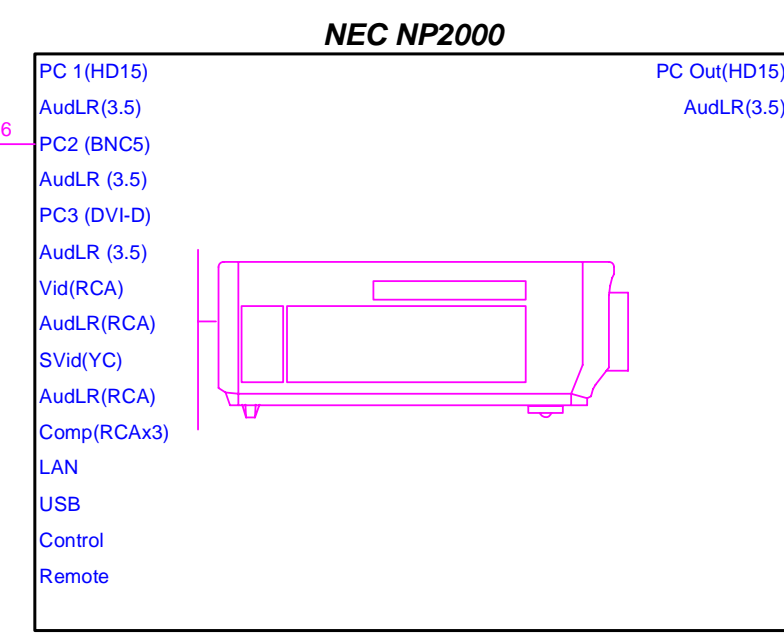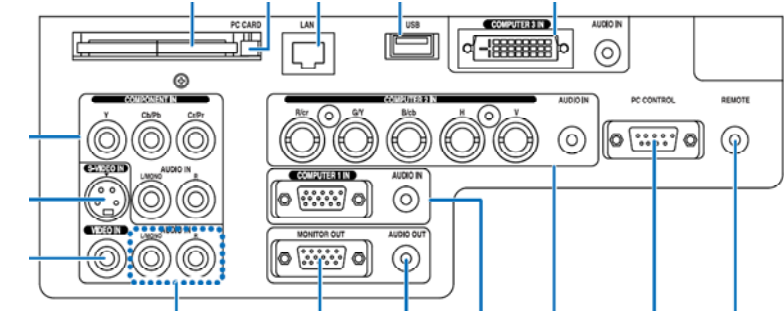


Last Rev:	As Built	08/02/07
Print Date:		11/14/07
Proj. Eng:		
Drawn By:		11/11/07

FRONTIER
MEDIA SOLUTIONS, LLC.

P.O. Box 634
Springboro, Ohio 45066
Tel: 937.704.9731 Fax: 937.704.0006
www.frontiermediasolutions.com

CUSTOMER	Christ Hospital
PROJECT	MA4538
DWG TITLE	Video Block
ma4538.vsd	DWG NUMBER MA4538
SCALE 1 ft.:1 ft.	AV 02

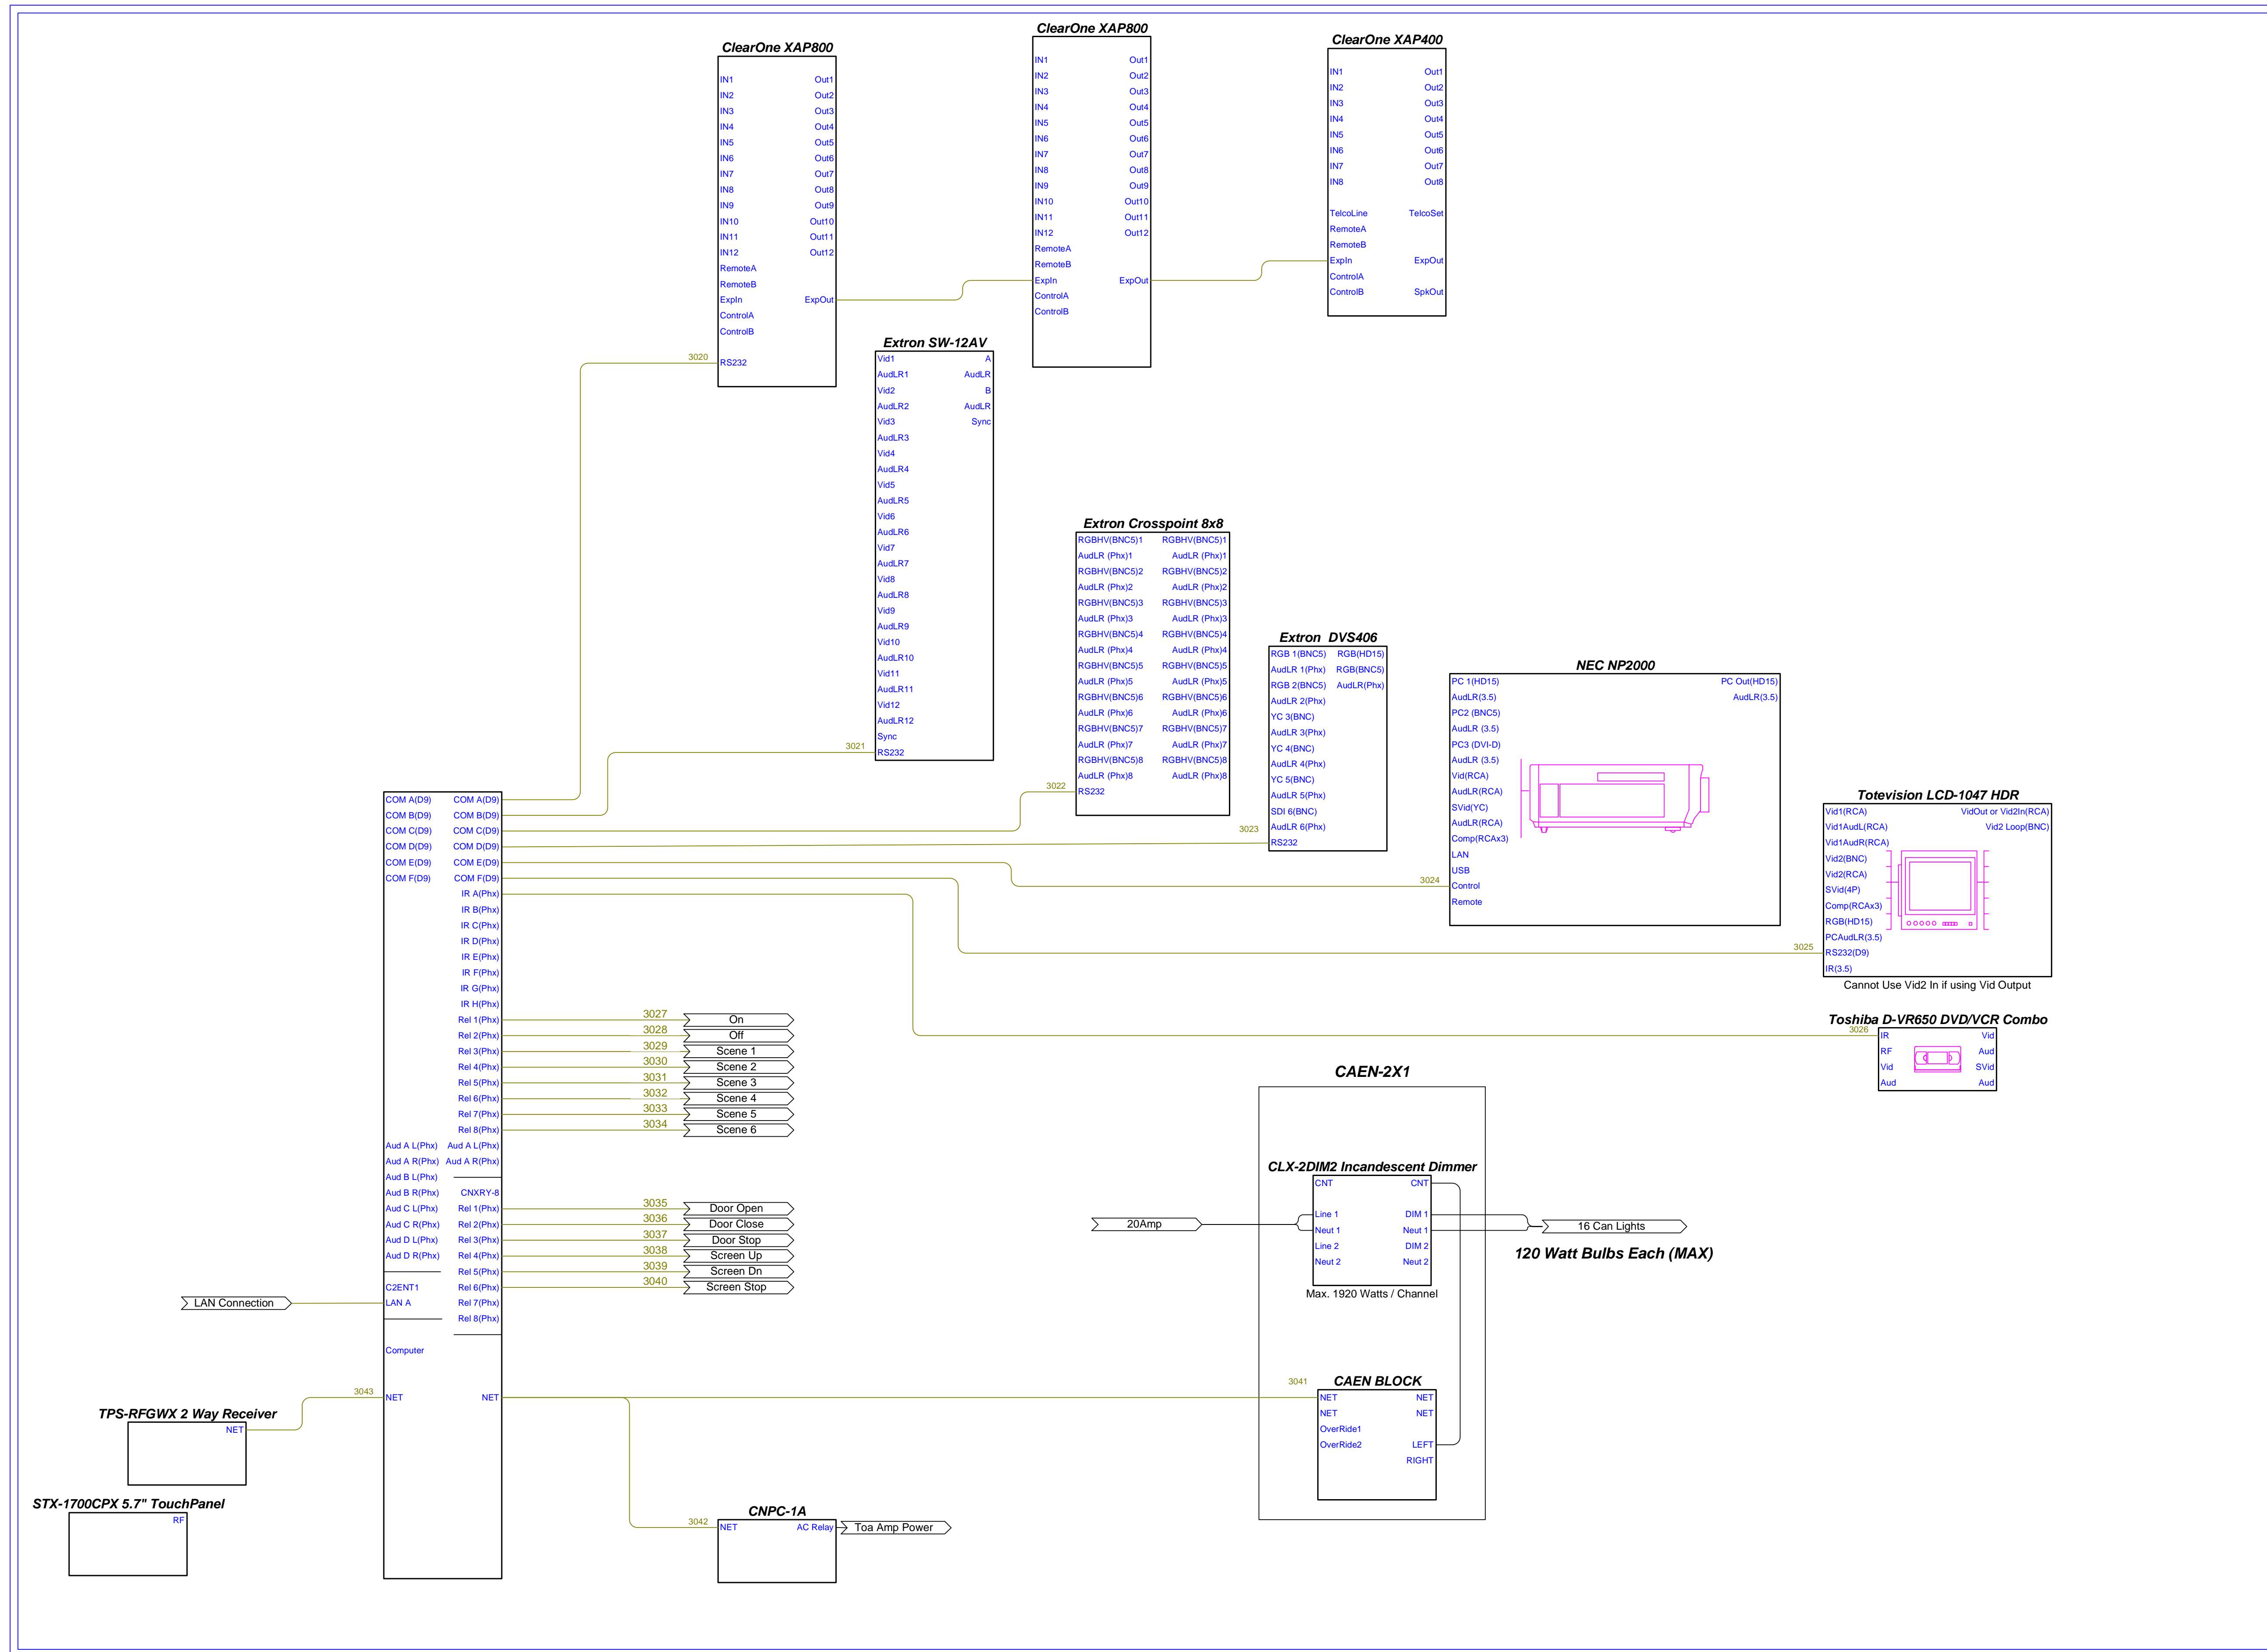

Wiring Index

Audio - Microphone	0000-0999
Audio - Line	1000-1999
Audio - Speaker	2000-2999
Control	3000-3999
Video - Composite/Svideo	4000-4999
Video - VGA/Component	5000-5999
Video - RF	6000-6999
Power	7000-7999
Fiber - Category	8000-8999
Spare	9000-9999


Last Rev:	As Built	08/02/07
Print Date:		11/14/07
Proj. Eng:		
Drawn By:		11/11/07

FRONTIER
MEDIA SOLUTIONS, LLC.

P.O. Box 634
Springboro, Ohio 45066
Tel: 937.704.9731 Fax: 937.704.0006
www.frontiermediasolutions.com


CUSTOMER	Christ Hospital
PROJECT	MA4538
DWG TITLE	Control Block
ma4538.vsd	DWG NUMBER MA4538
SCALE 1 ft.:1 ft.	AV 03

FRONT

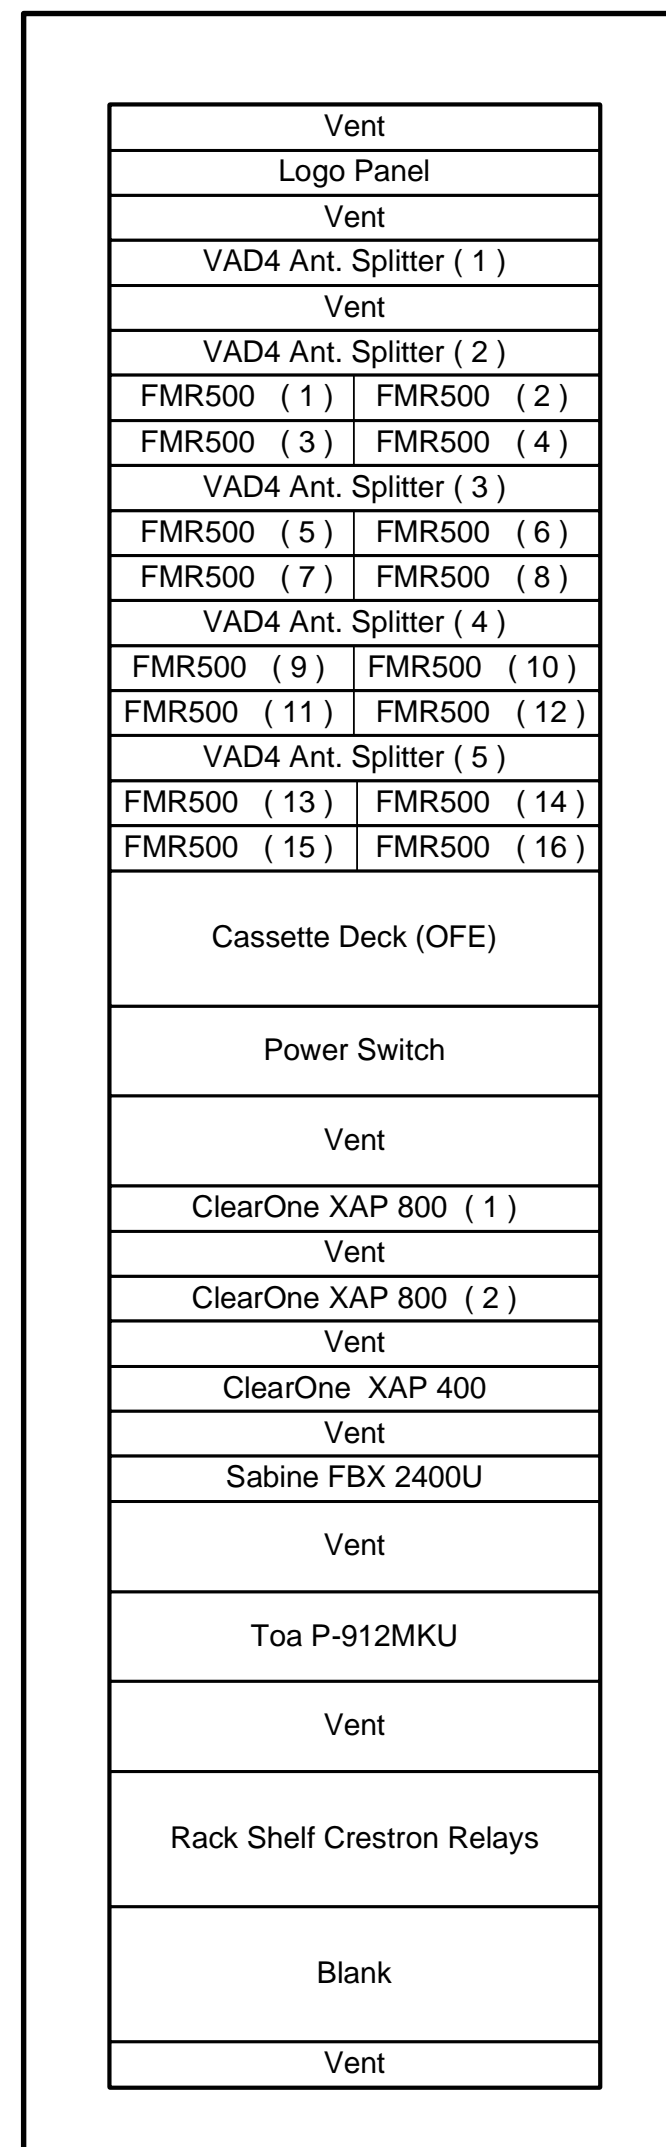


EqRack 1

BACK

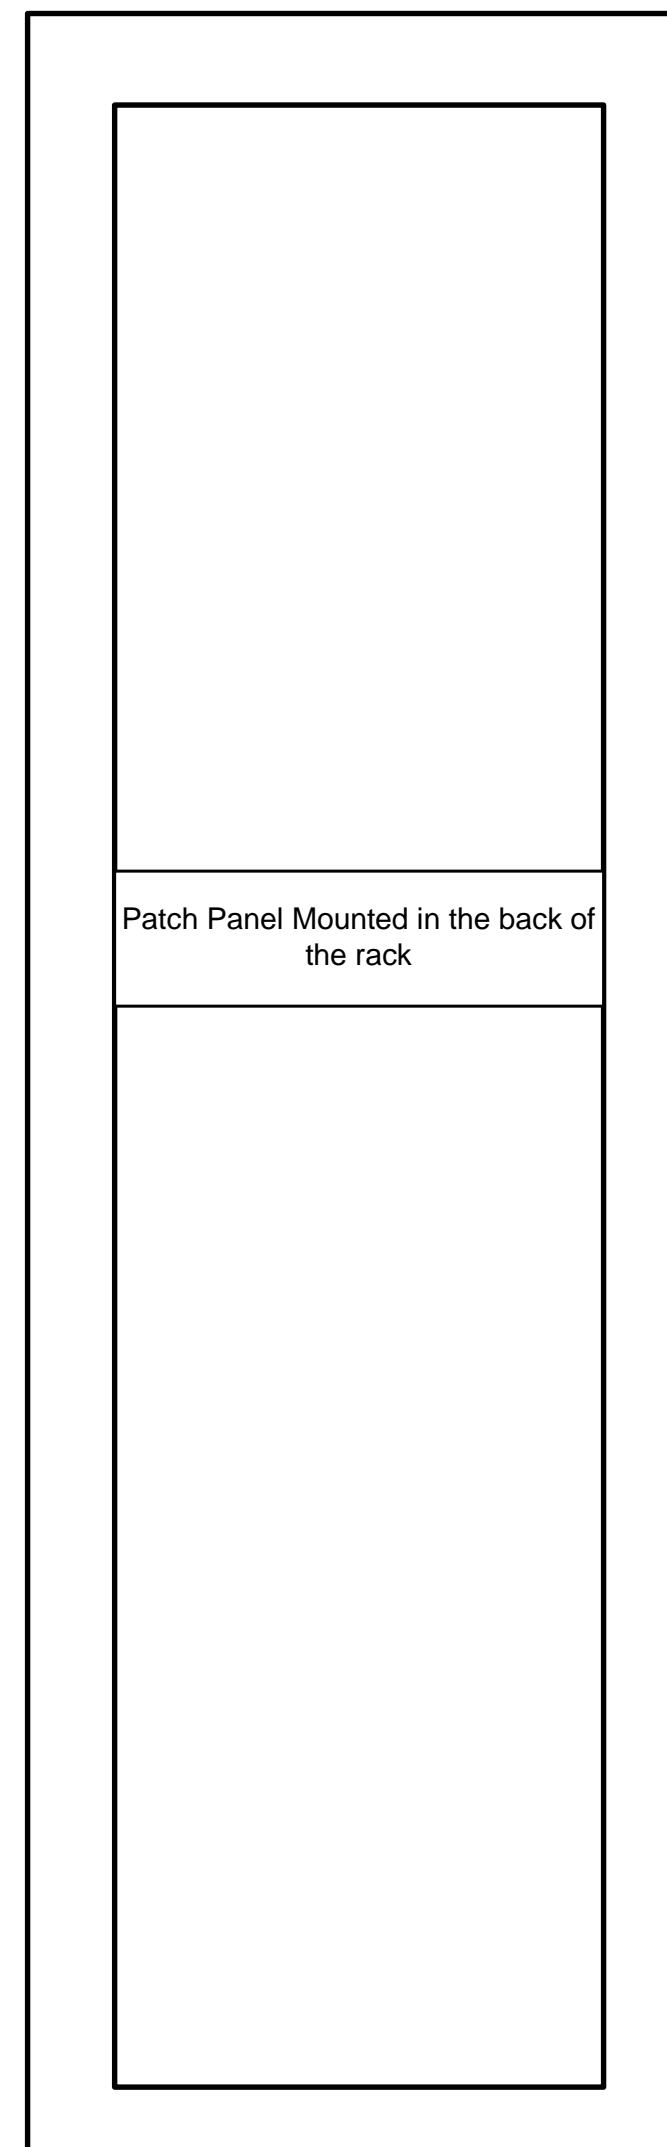


EqRack 1

FRONT

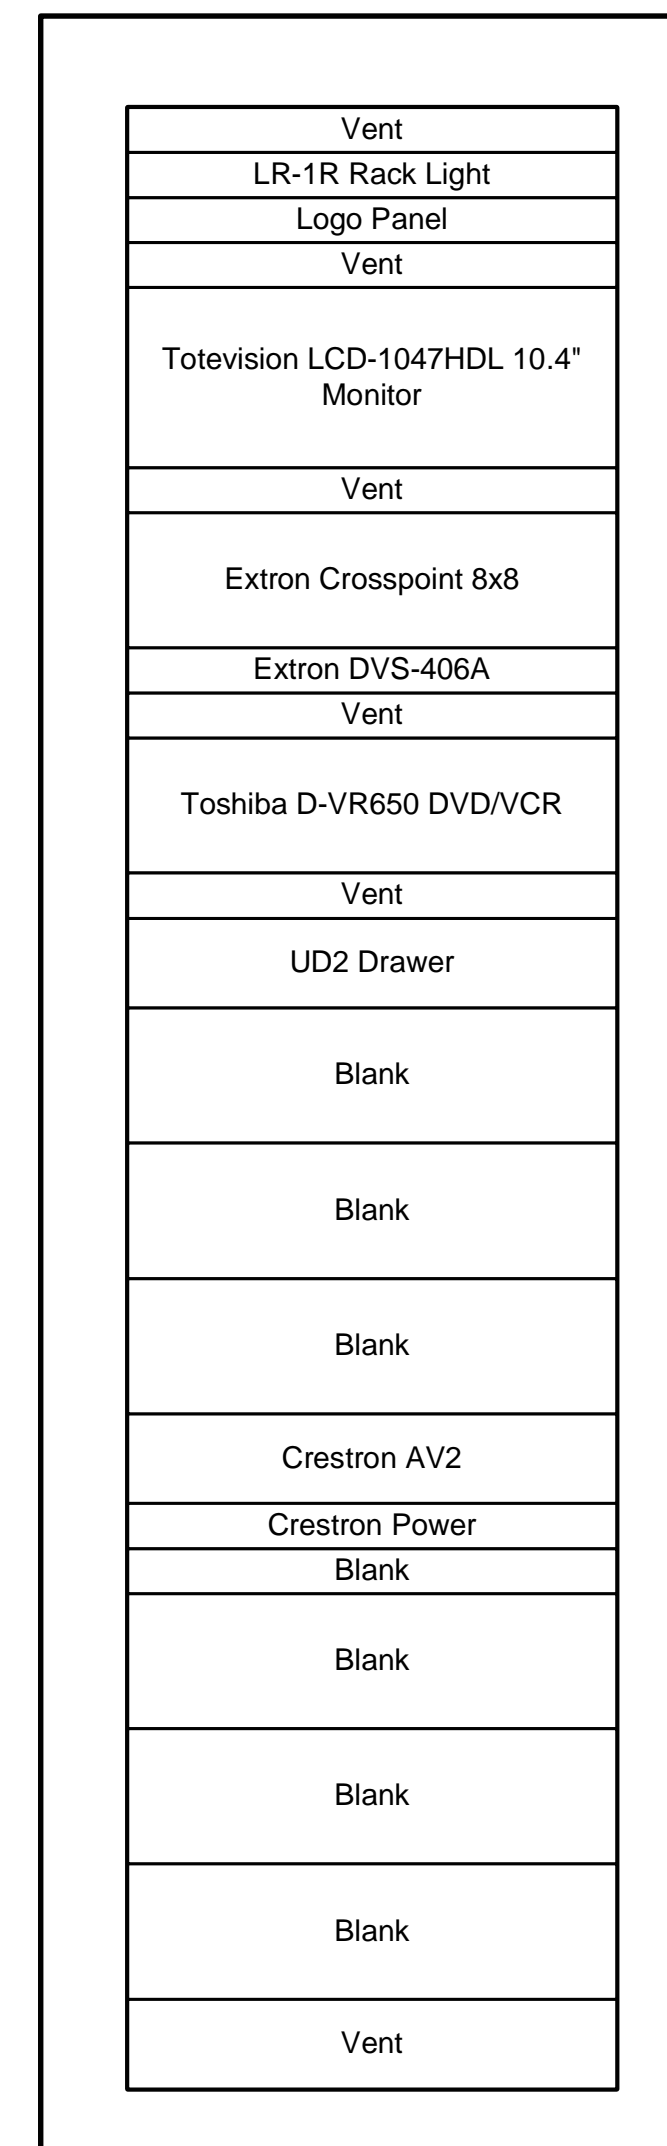

EqRack 2

BACK

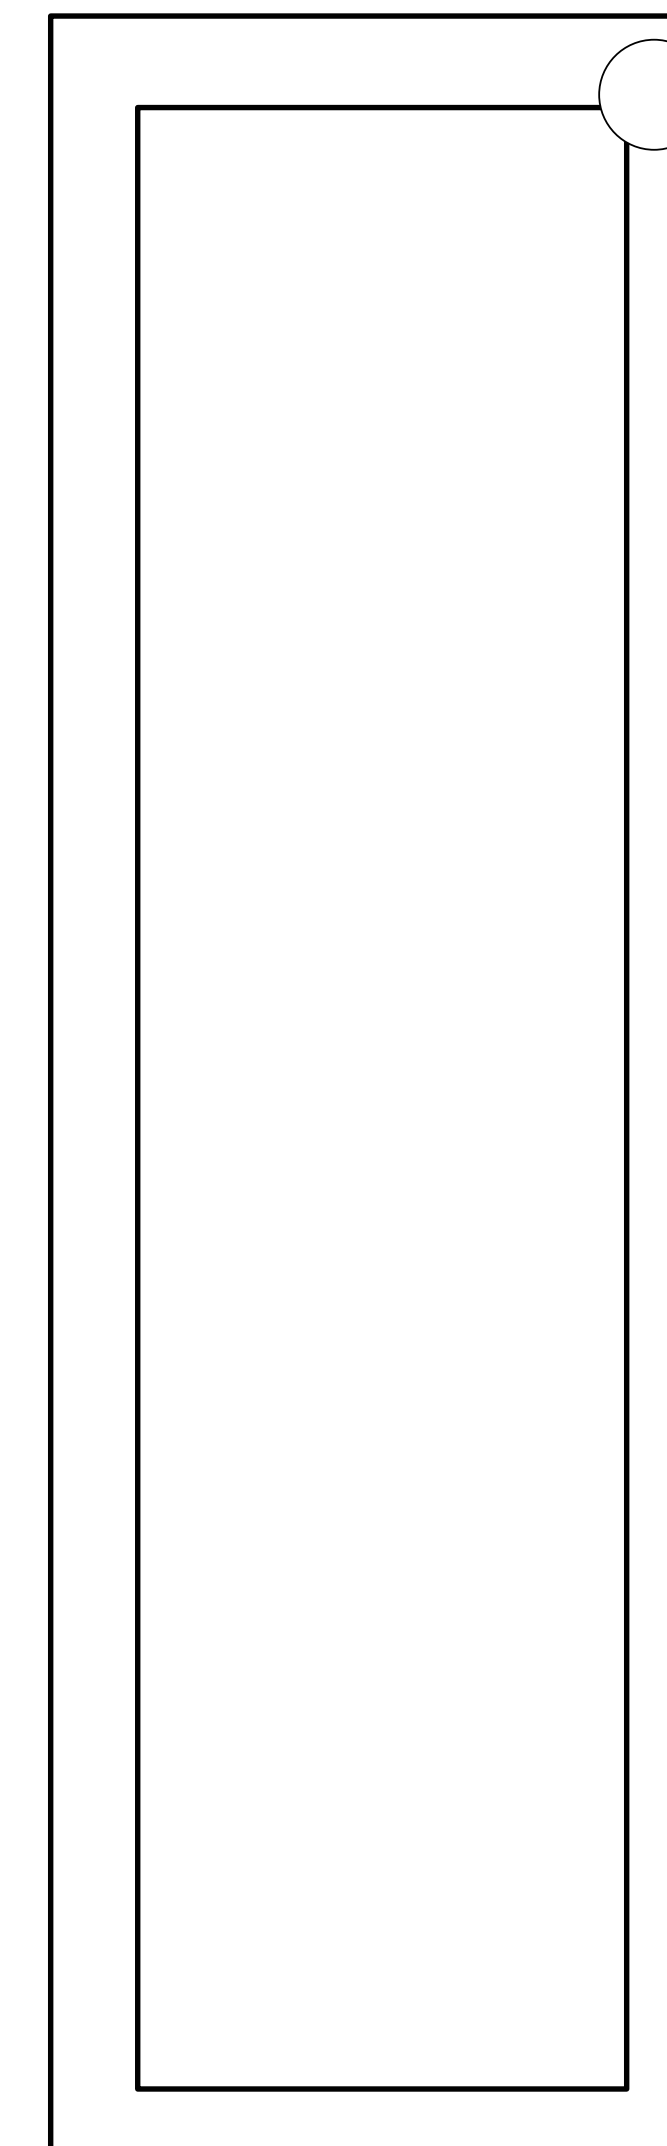

EqRack 2

Wiring Index

Audio - Microphone	0000-0999
Audio - Line	1000-1999
Audio - Speaker	2000-2999
Control	3000-3999
Video - Composite/Svideo	4000-4999
Video - VGA/Component	5000-5999
Video - RF	6000-6999
Power	7000-7999
Fiber - Category	8000-8999
Spare	9000-9999

Last Rev:	As Built	08/02/07
Print Date:		11/14/07
Proj. Eng:		
Drawn By:		11/11/07



P.O. Box 634
Springboro, Ohio 45066
Tel: 937.704.9731 Fax: 937.704.0006
www.frontiermediasolutions.com

CUSTOMER	Christ Hosptial
PROJECT	MA4538
DWG TITLE	Rack Layouts
ma4538.vsd	DWG NUMBER MA4538
SCALE 1 ft.:1 ft.	AV 04